
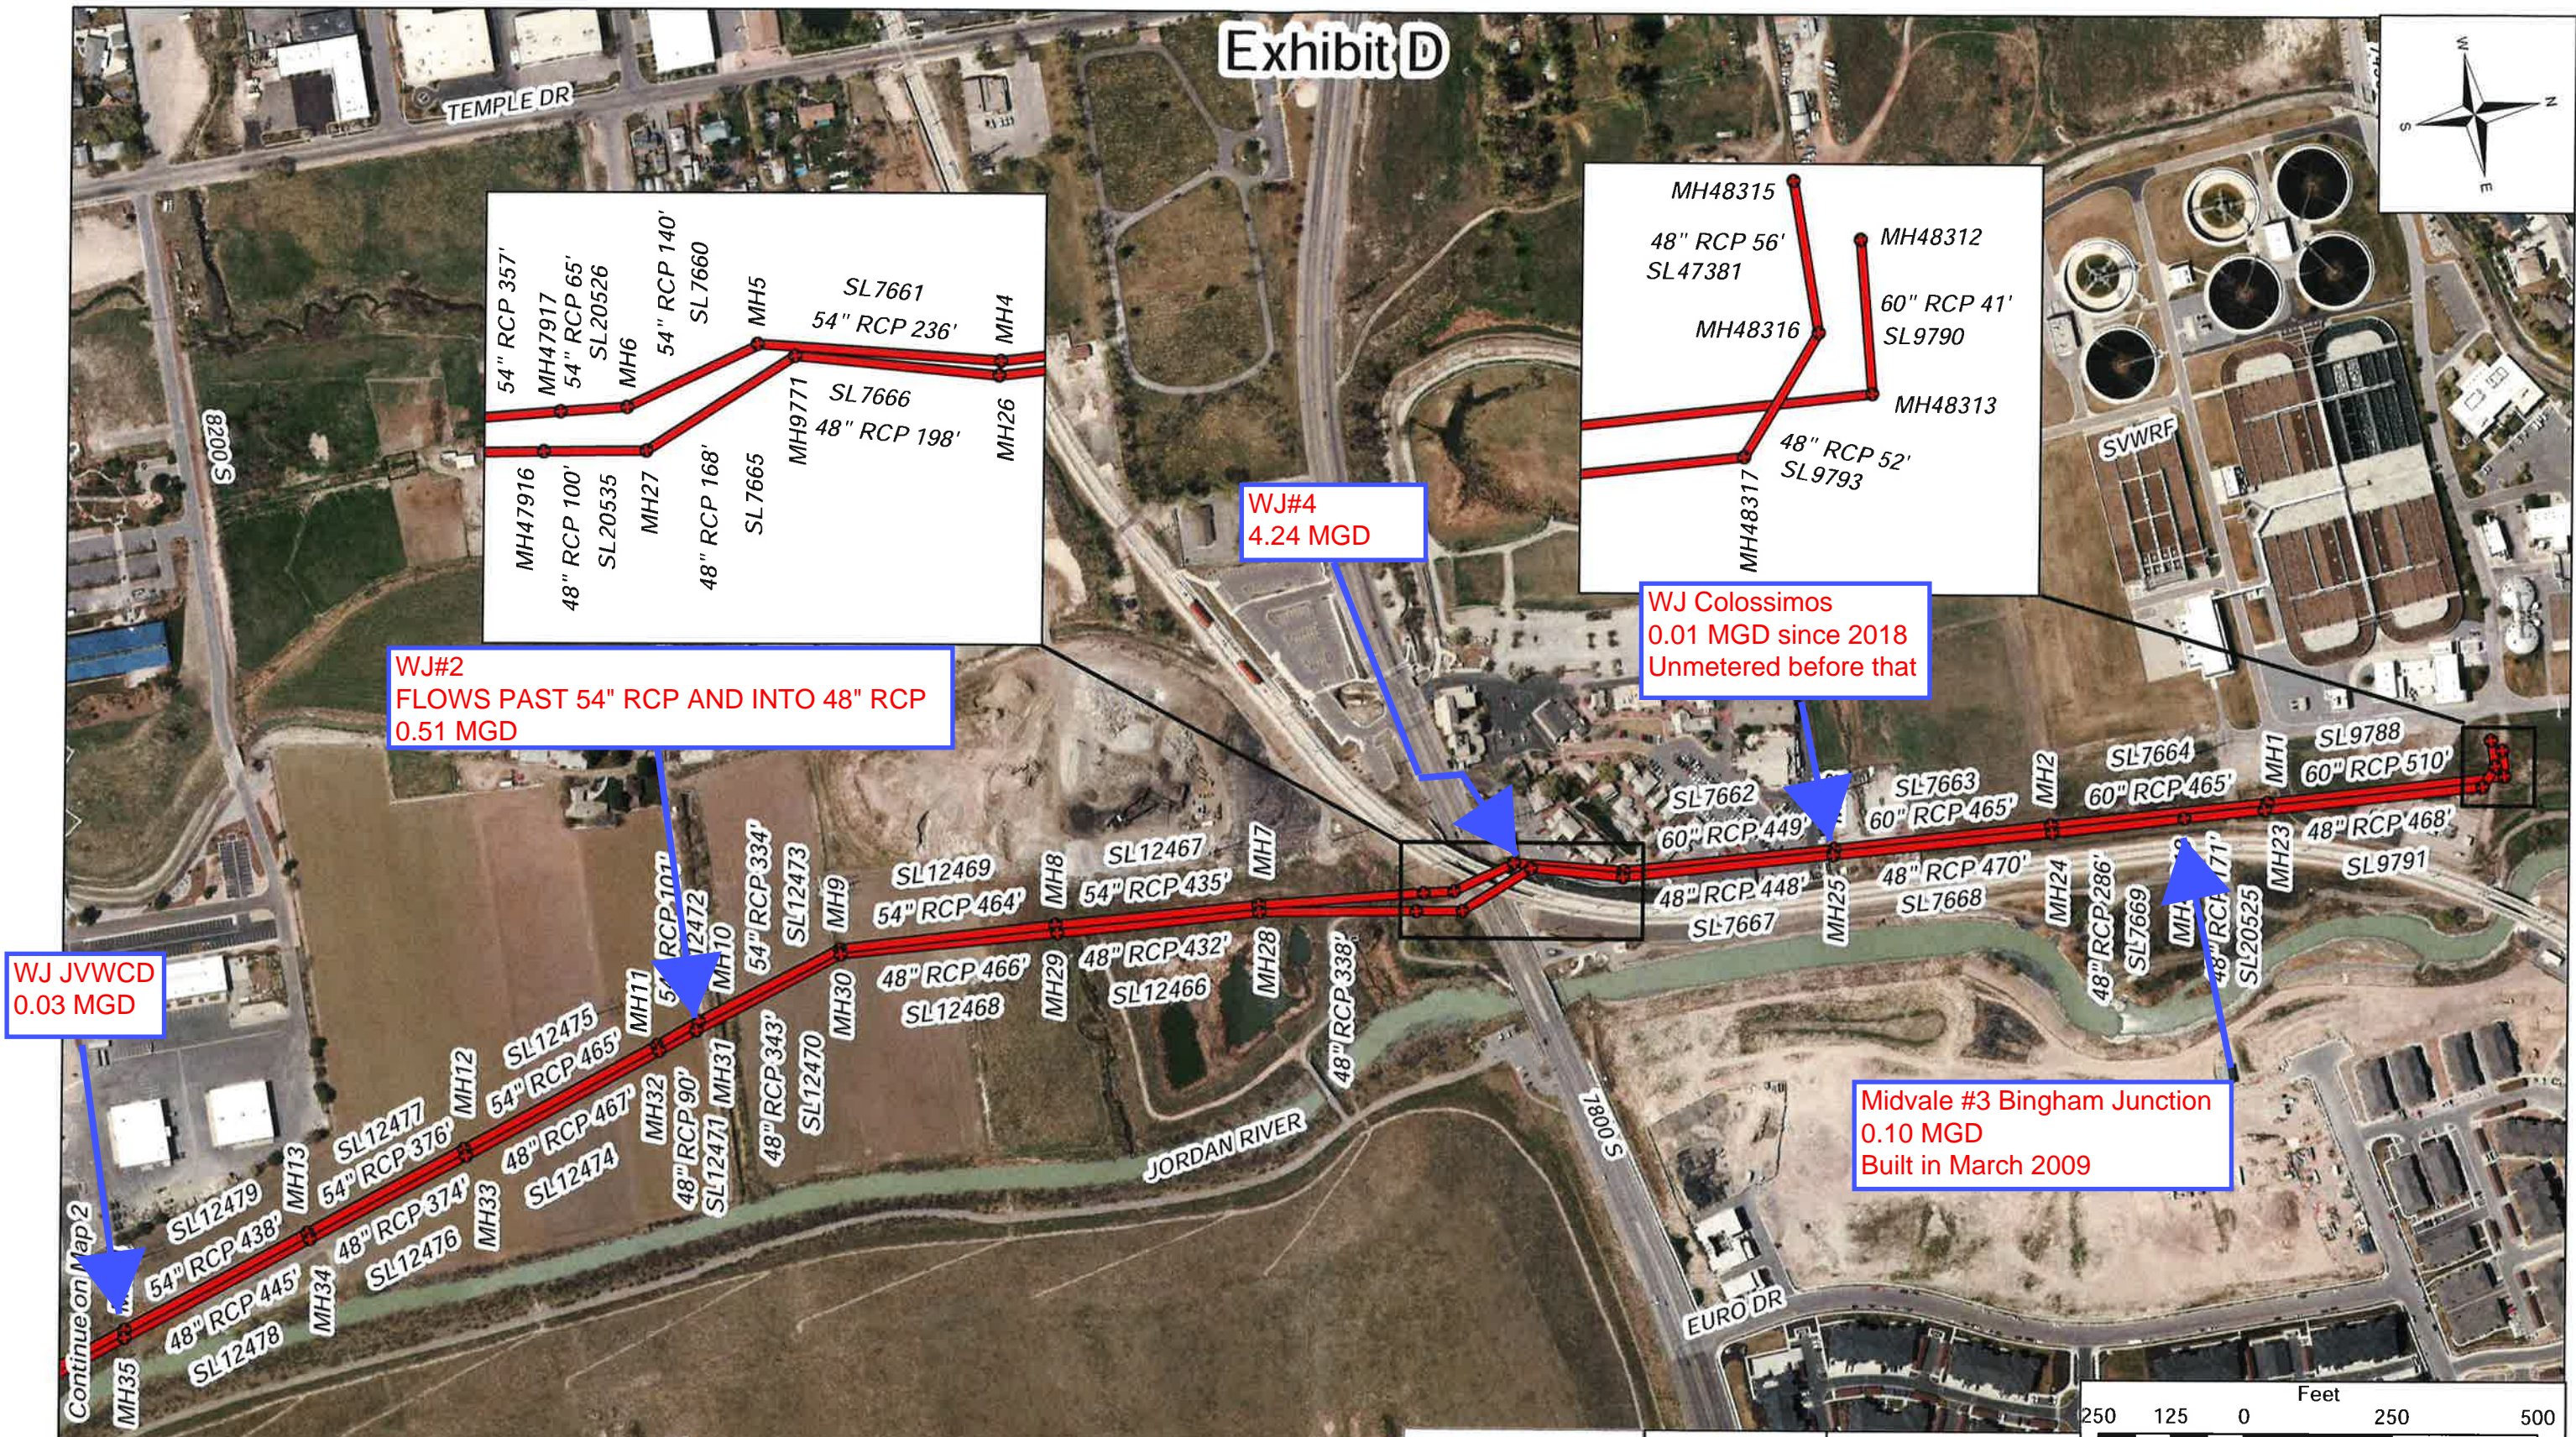


Exhibit D

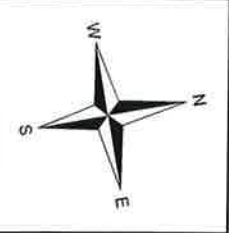

WJ JVVCD
0.03 MGD

WJ#2
FLOWS PAST 54" RCP AND INTO 48" RCP
0.51 MGD

WJ#4
4.24 MGD

WJ Colossimos
0.01 MGD since 2018
Unmetered before that

Midvale #3 Bingham Junction
0.10 MGD
Built in March 2009

Continue on Map 2


Project 1A Quantities

Manholes	58
Structures	1
48" RCP	9,074 FT
54" RCP	8,847 FT
60" RCP	1,930 FT





Legend

- Project 1A (Red cross symbol)
- Project 1A (Red line symbol)

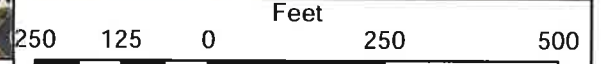

Project 1A
Map 1

Exhibit D

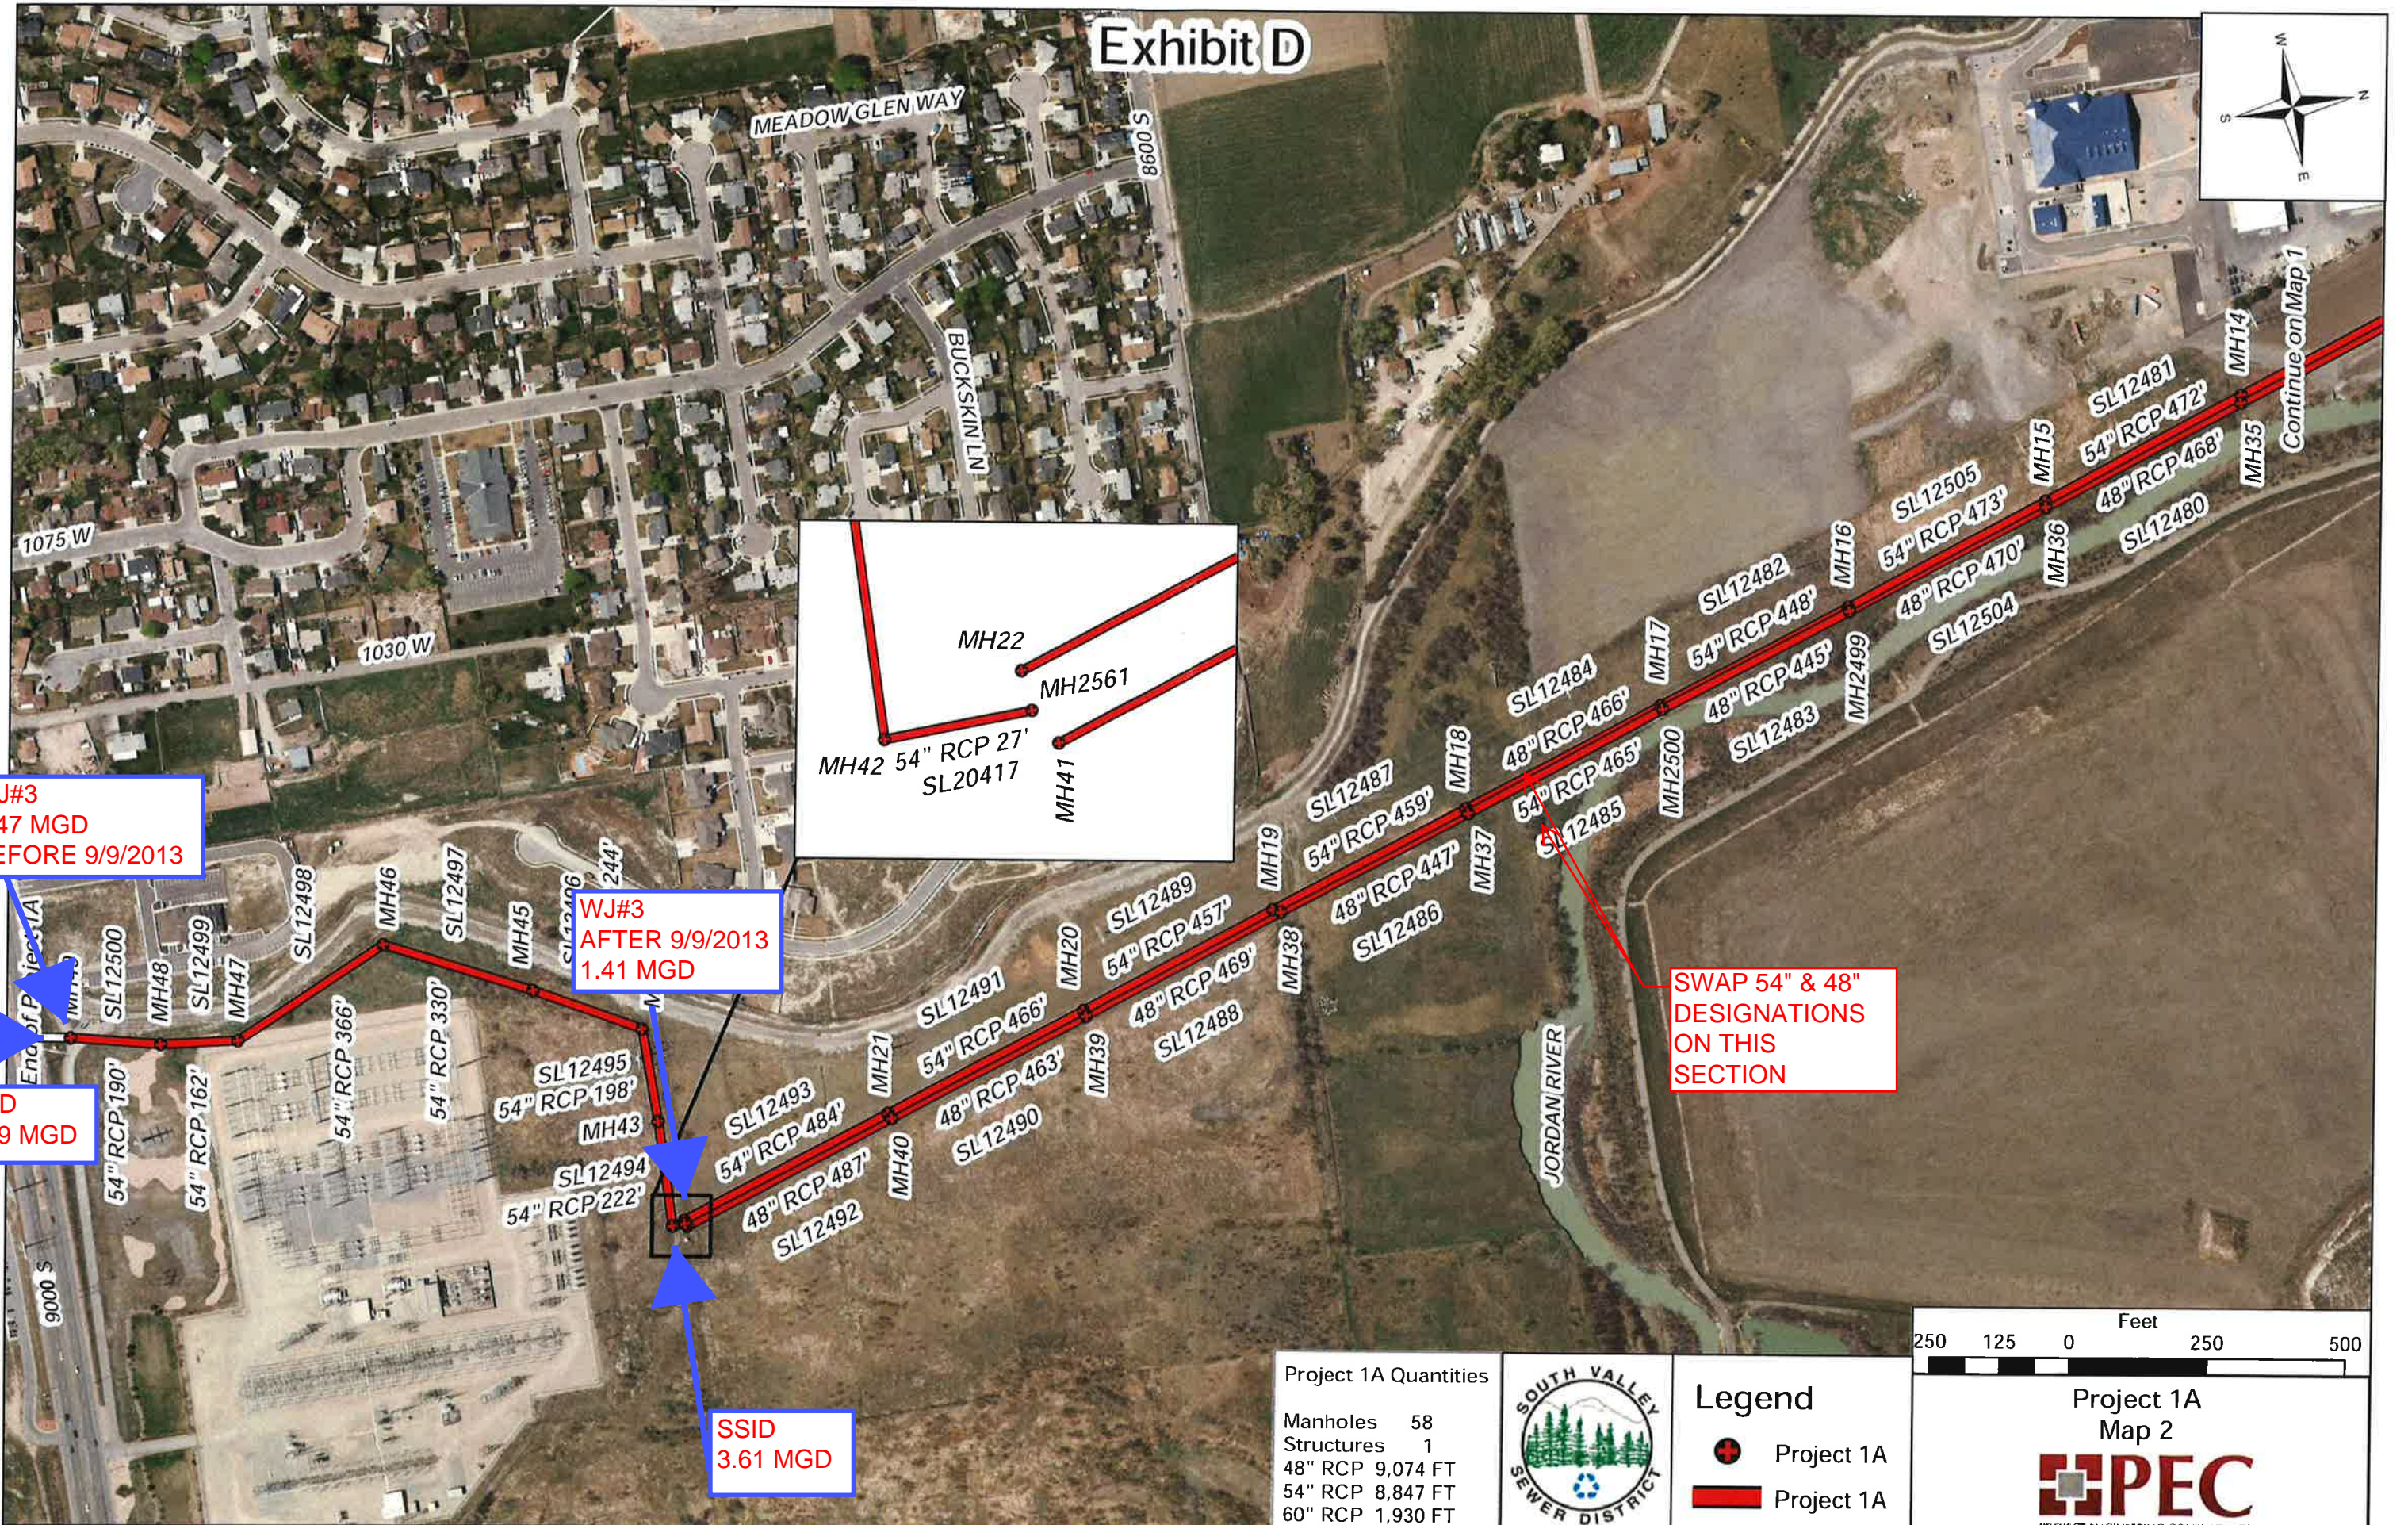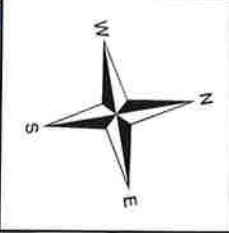


WJ#3
1.47 MGD
BEFORE 9/9/2013

WJ#3
AFTER 9/9/2013
1.41 MGD

SVSD
10.99 MGD

SSID
3.61 MGD

SWAP 54" & 48"
DESIGNATIONS
ON THIS
SECTION

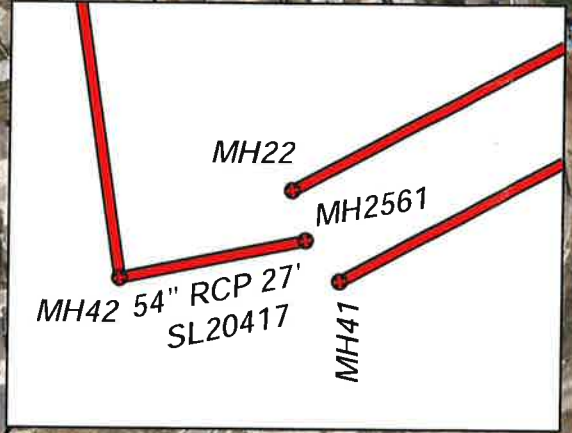


Project 1A Quantities

Manholes	58
Structures	1
48" RCP	9,074 FT
54" RCP	8,847 FT
60" RCP	1,930 FT



Legend

	Project 1A
	Project 1A

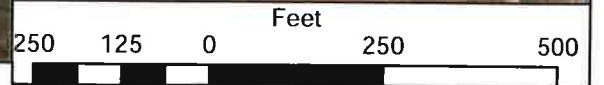

Project 1A
Map 2